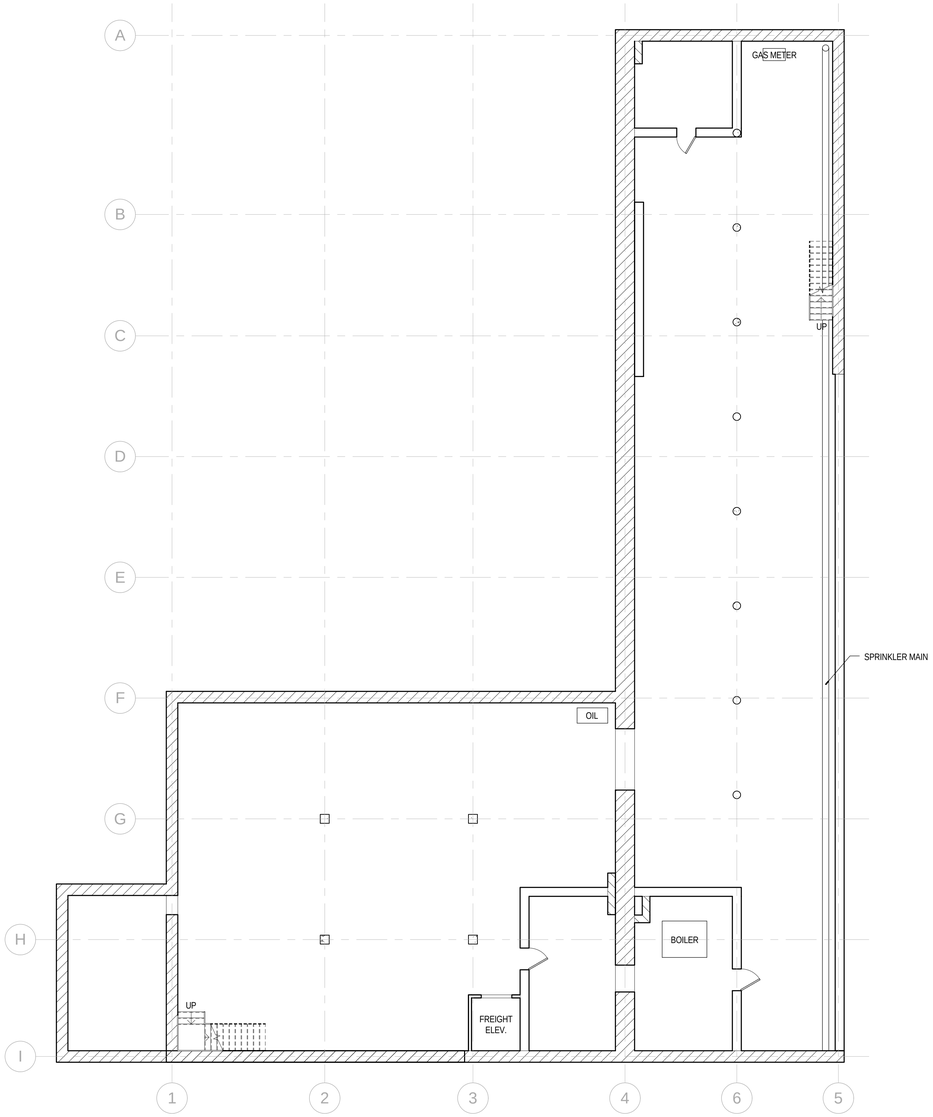

1 A-100 EXISTING PLAN - BASEMENT - 7,185 FT²
1/8" = 1'-0"

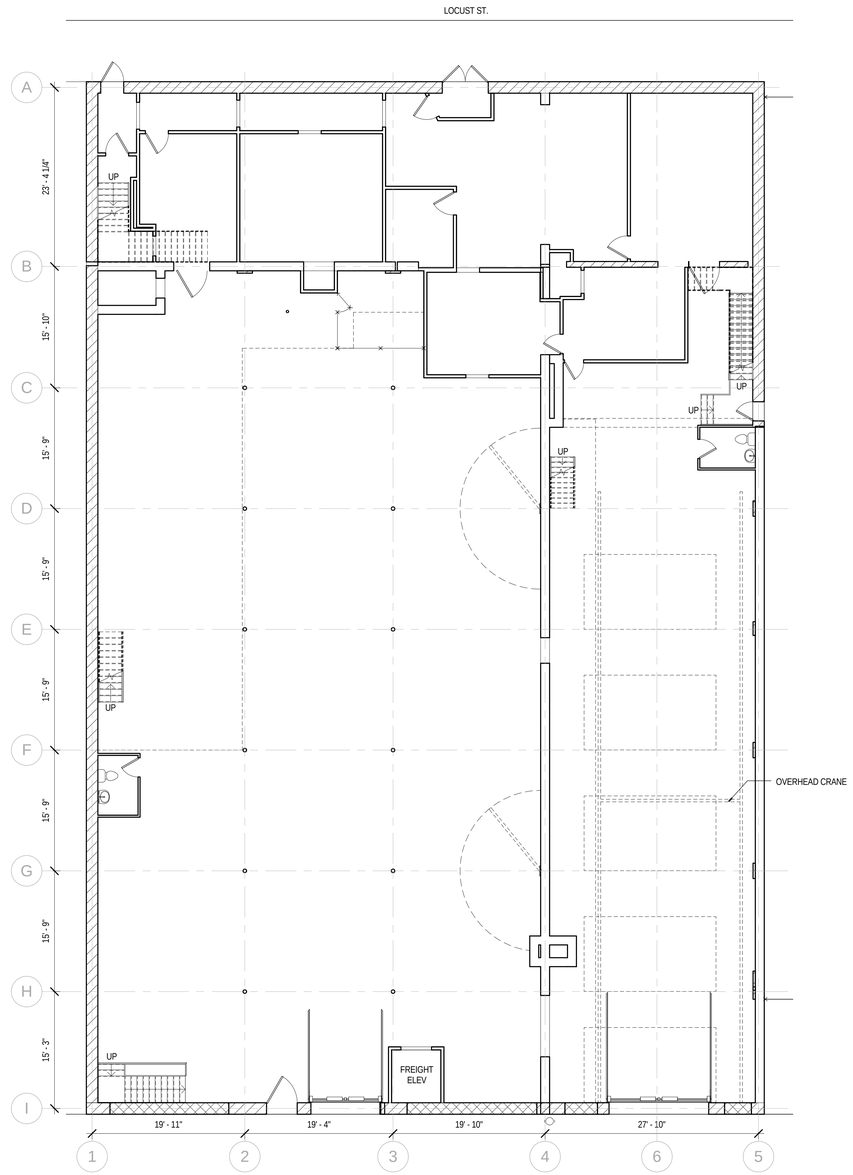

2 A-100 EXISTING PLAN - FIRST FLOOR - 11,908 FT²
1/8" = 1'-0"

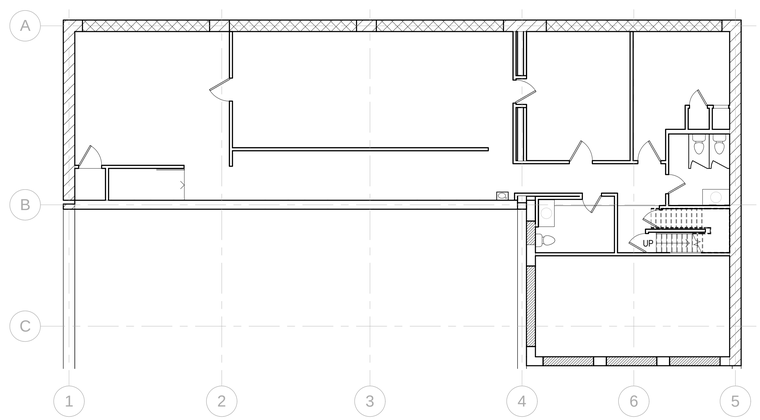

3 A-100 EXISTING PLAN - SECOND FLOOR - 2,751 FT²
1/8" = 1'-0"

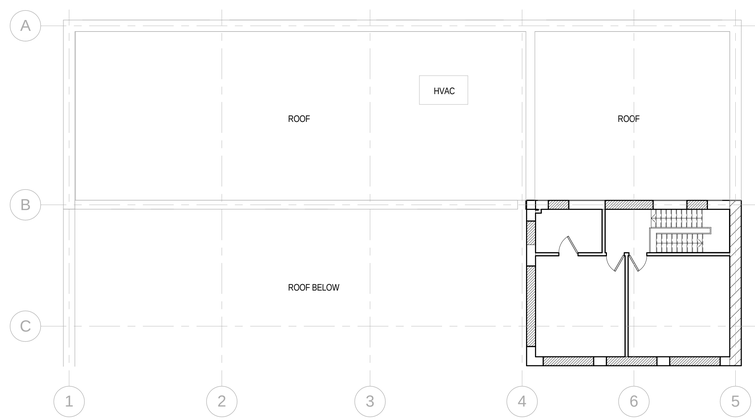

4 A-100 EXISTING PLAN - THIRD FLOOR - 605 FT²
1/8" = 1'-0"

2806 LOCUST ST.
ST. LOUIS, MO 63103

JEMA
planning architecture interior design

ARCHITECT
JEMA
3005 LOCUST ST.
ST. LOUIS, MO 63103
T (314) 531-7400
CONTACT:
E-MAIL:

No.	Date	Description
	11/06/17	EXISTING PLANS

DRAWN BY: JMHM

PROJECT NUMBER: 16-1157.00

SHEET TITLE:
2800 LOCUST ST. EXISTING PLANS

A-100